




ELEVATION FROM OFFICE.  
8 No REQUIRED.  
DLG-001, DLG-0026, D00-0001, D01-0001, D02-0001,  
D03-0001, D04-0001, D05-0001.

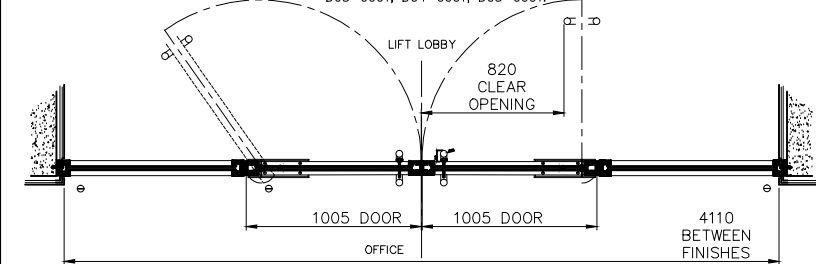

PYROSTYLE EI60S FIRE RATED FOR INTEGRITY & INSULATION WITH CONTINUOUS SMOKE SEAL. CERTIFICATED TO BS EN 1634-1:2000. GLAZED WITH 25mm PYROGUARD GLASS 54 KG PER SQ METRE

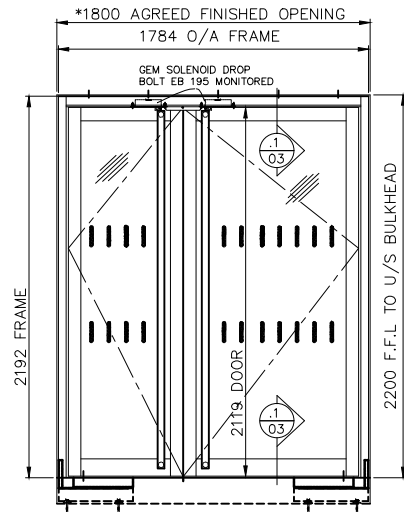


ELEVATION FROM LOBBY.  
1 No REQUIRED.  
DB1-0012

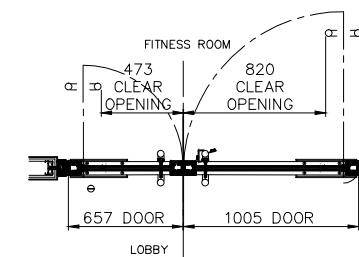


PYROSTYLE EI30S FIRE RATED FOR INTEGRITY & INSULATION WITH CONTINUOUS SMOKE SEAL. CERTIFICATED TO BS EN 1634-1:2000. GLAZED WITH 25mm PYROGUARD GLASS 54 KG PER SQ METRE


CONCEALED TRANSOM MOUNTED ACCESS CONTROL, EB195 SOLENOID DROP BOLTS (MONITORED). P.S.U WIRING AND CONNECTION BY OTHERS.

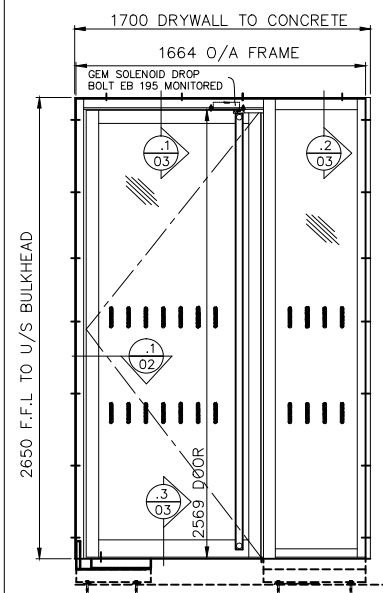



ELEVATION FROM OFFICE.  
1 No REQUIRED.  
D00-0031

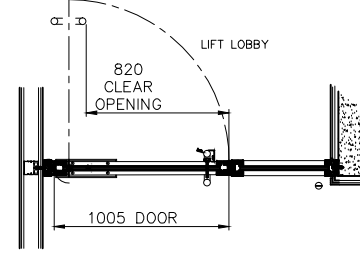


PYROSTYLE EI30S FIRE RATED INTEGRITY & INSULATION WITH CONTINUOUS SMOKE SEAL. CERTIFICATED TO BS EN 1634-1:2000. GLAZED WITH 25mm PYROGUARD GLASS. 54 KG PER SQ METRE.

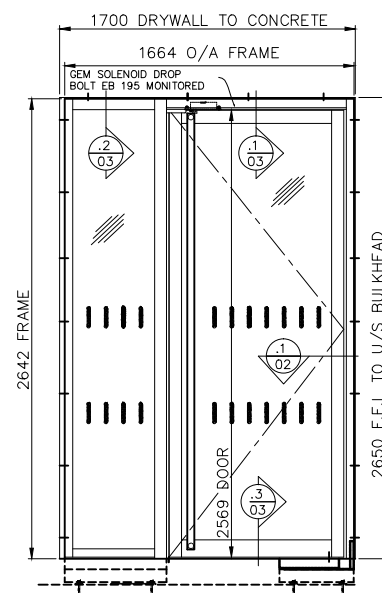


ELEVATION FROM OFFICE.  
1 No REQUIRED.  
D00-0028

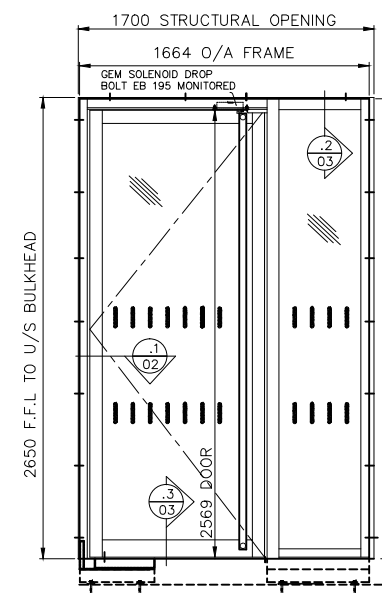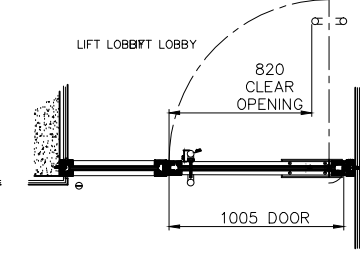


ELEVATION FROM OFFICE.  
1 No REQUIRED.  
D00-0030

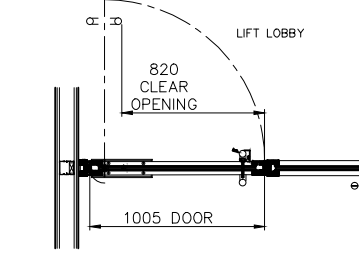

PYROSTYLE EI60S FIRE RATED INTEGRITY & INSULATION WITH CONTINUOUS SMOKE SEAL. CERTIFICATED TO BS EN 1634-1:2000. GLAZED WITH 25mm PYROGUARD GLASS. 54 KG PER SQ METRE.

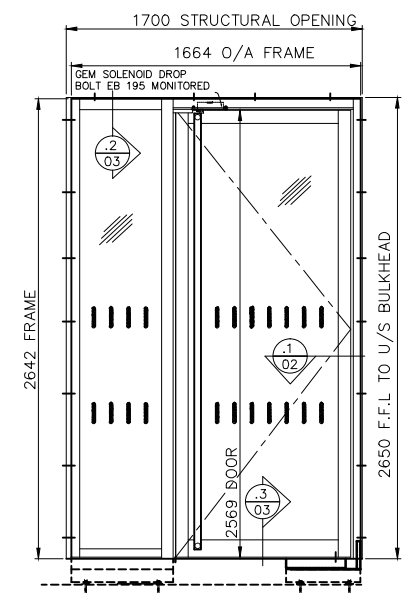

ELEVATION FROM OFFICE.  
1 No REQUIRED.  
D00-0029

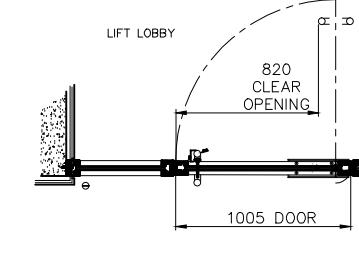

THE DOOR SIZE AND WEIGHT COMBINED WITH GEZE TS550 FLOOR SPRING (ADJUSTABLE OPENING / CLOSING FORCE) ARE CAPABLE OF COMPLYING WITH GUIDELINE PART M 30n/22.5n OPENING FORCE PROVIDING THAT DIFFERING AIR PRESSURE ZONES OR CLASHES WITH FINISHES ARE NOT IN CONFLICT.

1.2mm STAINLESS STEEL 304, 240 GRIT SATIN POLISHED CLADDINGS. GEZE TS550 NV FLOOR SPRINGS. (ADJUSTABLE FORCE & SPEED) Ø40mm FULL HEIGHT PULL HANDLE S/S 304, 240 GRIT SATIN POLISHED. MANIFESTATION 3M DUSTED CRYSTAL APPLIED VINYL FILM (FIRE ATTACK SIDE ONLY) BY S.F

THIS DRAWING WAS PREPARED BY STEWART FRASER LTD. & IS THE SUBJECT OF COPYRIGHT. IT MUST NOT BE REPRODUCED OR USED WITHOUT PERMISSION.

DO NOT SCALE

REVISIONS

REVISED TO COMMENTS. RATING ADJUSTED & SCOPE D00-001 OMITTED. REVISION 01 20.09.17	SCREEN HT OF 7 No 4 BAY SCREENS REDUCED 50mm. REVISION 02 25.09.17	PREVIOUSLY OMITTED SCREEN REF D00-0001, REINSTATED. REVISION 03 02.10.17	SCREEN HT'S ADJUSTED. DOOR WIDTHS WERE 1055mm REVISION 04 09.10.17	AS BUILT REVISION AB 21.03.18
---	--	--	---	----------------------------------

Q/F 040-02-0412

**STEWART FRASER**  
HENWOOD INDUSTRIAL ESTATE, ASHFORD, KENT, TN24 8DR  
TELE : 01233 625911 FAX 01233 633149  
E-Mail : ajsaunders@stewartfraser.com Website : www.stewartfraser.com

Client: P. J. HEGARTY & SONS			
Title: 10 MOLESWORTH STREET, DUBLIN 2 PYROSTYLE E120/EI60 & EI30 SCREENS			Drawn by: A J S
Date: 21.03.18	Drg Status: AS BUILT	Drawing no: 701195.01	Rev AB